NOTES

1. FE = PROVIDE PORTABLE FIRE EXTINGUISHERS, DRY CHEMICAL TYPE (ABC TYPE EXTINGUISHER), PLACE IN A SEMI RECESSED NON LOCKING CABINET WITH WHITE ENAMEL FINISH IN METAL STUD WALLS, OR APPROVED MOUNTING BRACKETS FOR SIDES OF STEEL COLUMNS OR RACKS. HANDLE SHALL BE LOCATED AT 48" A.F.F. PROVIDE FIRE EXTINGUISHER SIGNAGE AS NEEDED. ALL COLUMNS WITH FIRE EXTINGUISHERS TO HAVE A RED BAND PAINTED ON COLUMN, HEIGHT TO BE DETERMINED BY FIRE MARSHALL.
2. ARCHITECT PROVIDES SUGGESTED LOCATION AND QUANTITY OF FIRE EXTINGUISHERS AND CABINETS ONLY: FIRE MARSHALL TO APPROVE EXACT QUANTITY AND LOCATION. (1)
3. EXIT ACCESS IN CLASS A AND B MERCANTILE OCCUPANCIES THAT ARE PROTECTED BY AN APPROVED, SUPERVISED AUTOMATIC SPRINKLER SYSTEM AND EXIT ACCESS IN ALL CLASS C MERCANTILE OCCUPANCIES, SHALL BE PERMITTED TO PASS THROUGH STOREROOMS, PROVIDED THAT ALL OF THE FOLLOWING CONDITIONS ARE MET:
   (1) NOT MORE THAN 50 PERCENT OF EXIT ACCESS SHALL BE PROVIDED THROUGH THE STOREROOM.
   (2) THE STOREROOM SHALL NOT BE SUBJECT TO LOCKING.
   (3) THE MAIN AISLE THROUGH THE STOREROOM SHALL BE NOT LESS THAN 44 INCHES WIDE.
   (4) THE PATH OF TRAVEL THROUGH THE STOREROOM SHALL BE DEFINED, DIRECT, AND CONTINUOUSLY MAINTAINED IN AN UNOBSTRUCTED CONDITION.

NFPA LIFE SAFETY CODE 2012 EDITION SECTION 36.2.5.11

LIFE SAFETY LEGEND

- TRAVEL PATH
- (X) FIRE EXIT
- (EX) ILLUMINATED EXIT SIGN
- (1) DOOR RATING
- 1 HOUR RATED WALL

NOTE: SEE ELECTRICAL DRAWINGS FOR ILLUMINATED EXIT SIGN LOCATIONS.

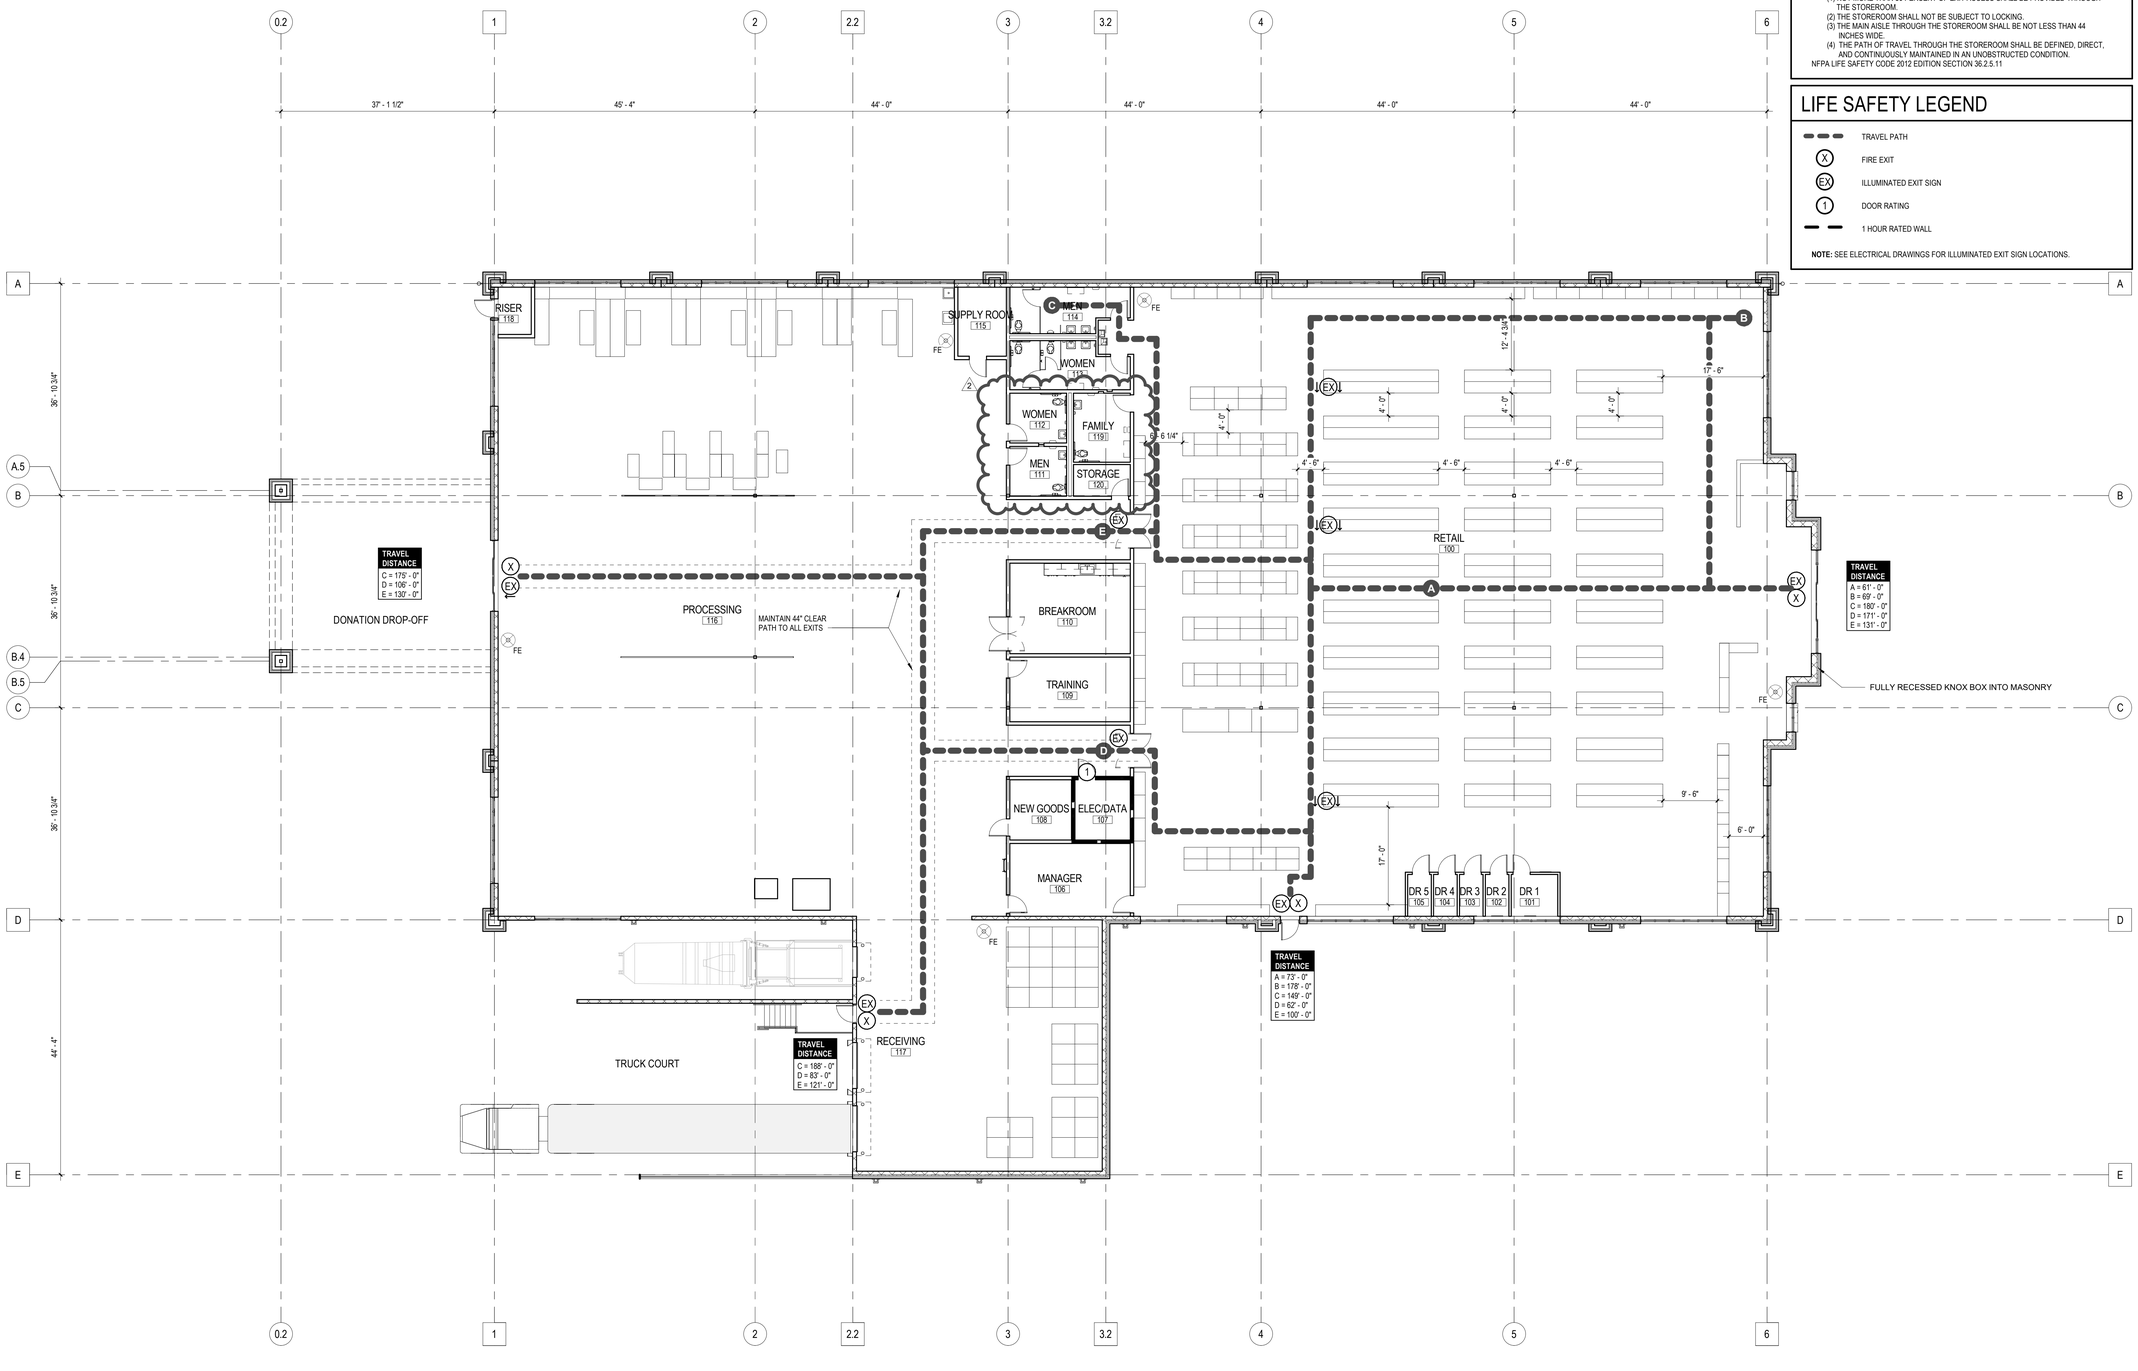

1 A-091 LIFE SAFETY PLAN

SCALE: 3/32" = 1'-0"

PROJECT NORTH

RANDALL PAULSON architects

STATE OF GEORGIA — ALEX PAULSON — CERTIFICATE NO. — REGISTERED ARCHITECT

February 1, 2019

Roswell Mill
85-A Mill Street, Suite 200
Roswell, Georgia 30075
t 770.650.7558 f 770.650.7559
e-mail info@randallpaulson.com

architecture/interiors

These plans and specifications are the property of Randall Paulson Architects, Incorporated. These documents may not be copied, reproduced, used or implemented in any way, in part or in whole, without the written consent of Randall Paulson Architects, Incorporated. All common law rights of copyright are hereby specifically reserved.

GOODWILL DULUTH

RETAIL AND DONATION FACILITY

developed by

GOODWILL OF NORTH GEORGIA

3064 PEACHTREE INDUSTRIAL BLVD.
DULUTH, GA

Print Record

05 OCTOBER 2018	PERMIT SET

Revision Record

1	18 OCT 2018	FIRE PLAN REVIEW COMMENTS
2	01 FEB 2019	A2.01 - BATHROOM REVISIONS

Date 05 OCTOBER 2018 *Project No.* 2018225.00

Sheet Title
LIFE SAFETY PLAN

Sheet No.
A-091

■ Released for Construction
□ Not Released for Construction